



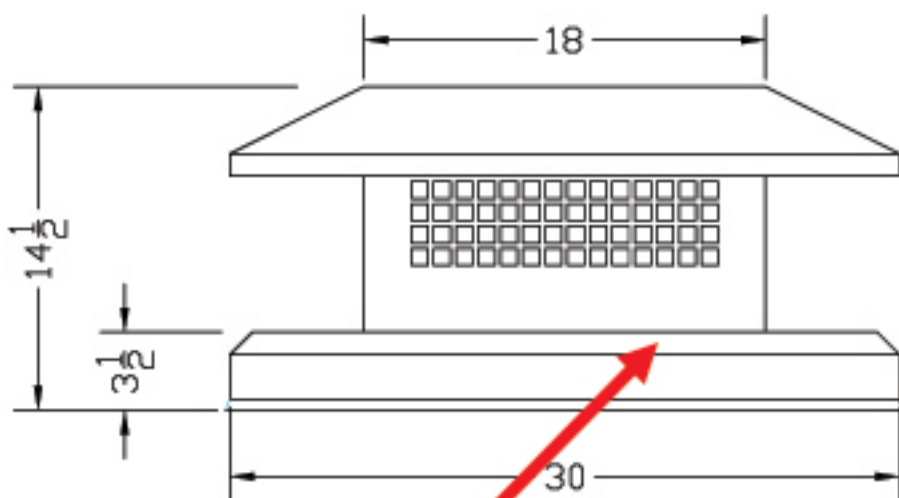

note chamfered edge

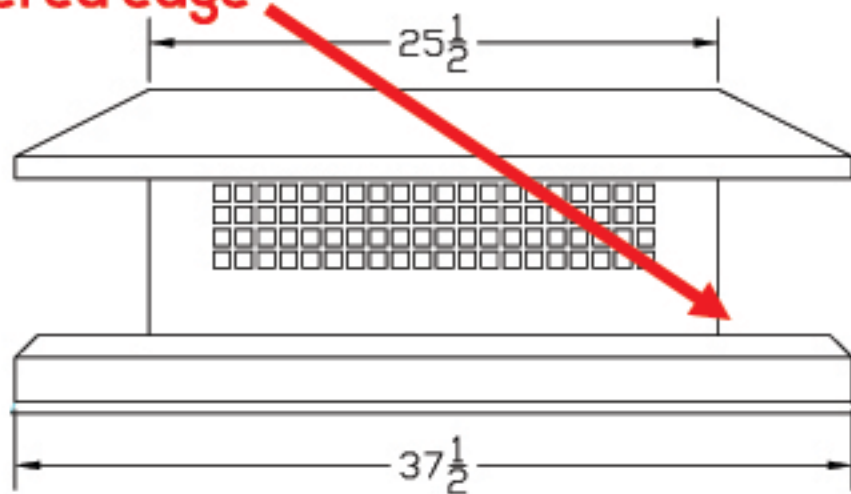

ACCEPTED PER DRAWING: _____ DATE: _____

PLEASE REVISE: _____ DATE: _____

VOLKO SUPPLY

205 Herkida Road Garden City Park, N.Y. 11040

These design-engineering concepts will remain the exclusive property of Volko Supply unless a separate purchase agreement to release the rights of the concepts and engineering is purchased.

CUSTOMER		SHIP BY	
DWG. NUMBER	41316.1	MATERIAL	16oz COPPER
MODEL#	Custom Dallas Chimney Caps	SCREEN	3/4" PUNCHED SCREEN FRAME
FINISH	Natural Copper	ACCESSORIES	
DRAWING DATE	4/13/16		